DOOR SPECIFICATIONS

PORTE METAL

Customer : DEMATHIEU BARD

Chantier : Affaire 1390 : ITER
Bâtiment : B37
Level : Ground Floor L1

Door Number : 63-37-L1-DO-0024 - (P19)

Location : PBS 26 aera

Clear Passage Wall :	Real clear Passage Wall :	Clear Passage Validated :
~~Widht : 1100 mm~~	Widht : mm	Widht : 1099 mm
~~Height : 2125 mm~~	Height : mm	Height : 2111 mm (4)
	Date **/**/**	

Clear passage Widht : (180°) : 945 mm
Clear passage Widht : (90°) : 926 mm (4)
Clear passage Height : 2035 mm

Support : Metallic Structure

Ind : 0	Date : 27/09/2021	Ind (2)	Date : 19/05/2023
Ind (1)	Date : 25/01/2023	Ind (3)	Date : 30/06/2023
		Ind (4)	Date : 07/08/2023

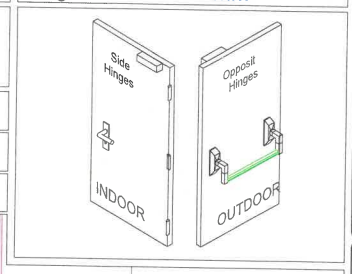

Brand's Door	PORTEMETAL
MSF : 37-0009	PREMIUM FONO
Door Performance : Fire Rating EI 90 25 dB	Frame type : TUNNEL
Opening side	LEFT Hand
RAL:	7035

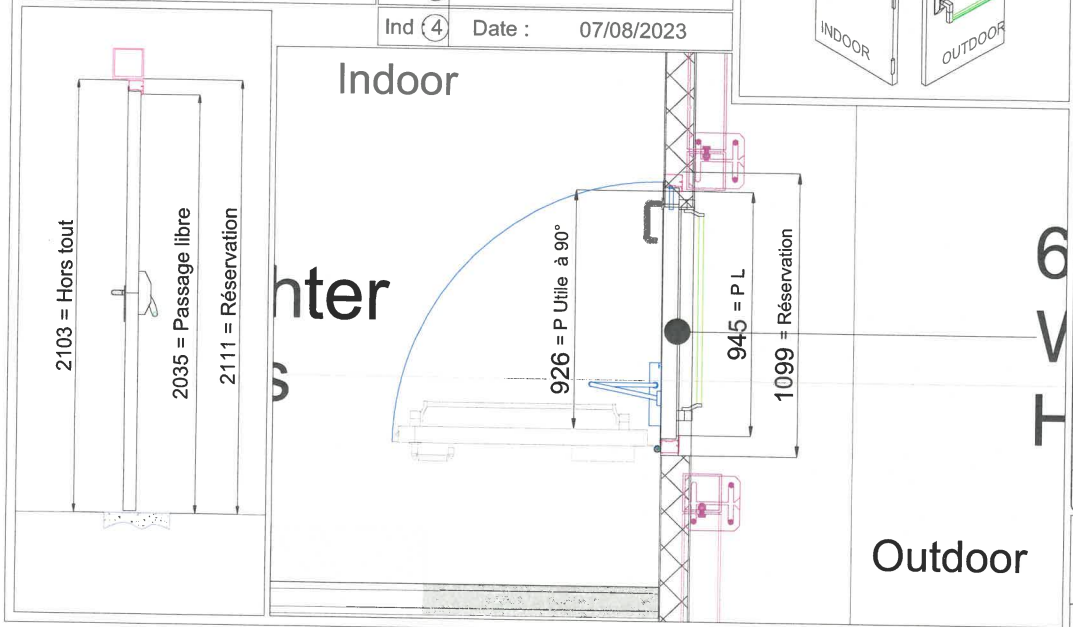

Repère	Equipments	Réf :	n° MSF
1	Handle to Stainless steel	PF1X	37-0025
2	Panic Lock 1pt (3)	S1F	37-0026
3	Panic Bar (3)	BA1	37-0025
4	European Cylinder Lock 45x45	C1	
5			
6	1 Door closer (SIDE Hinges)	TS83	37-0027
7			
8	1 Magnetic stop	9874M	(2)
9	~~End stop~~	~~AC14~~	(1) (2)

Bon pour accord le : 8/08/23

Nom + Signature : SERRESSEQUE

Une validation est définitive et aucune modification ne pourra être accordée.

Note : See to Doors Schedules : ARCHI-DBC-MRR-GL-37-0006

SUPPLIER DRAWING NO. DBC_EXE_DS_37_0046 (a)

REV. 04 VER. 0

ISSUER / SUPPLIER : DEMATHIEU BARD CONSTRUCTION

SUBCONTRACTOR : PORTE METAL

CONFIDENTIAL
© Fusion for Energy 2009
Reproduction or dissemination of this drawing is not authorized without the express written agreement of Fusion for Energy

F4E Barcelona

PHASE: PBS.63.37. CONSTRUCTION DESIGN

TITLE: Doors Specification - DO-0024 - P19

SHEET SIZE	SCALE	ISSUER ID	LIBRARY	DOC TYPE	DOC FAMILY	NUMBER	REVISION	SHEETS
A3	N/A	DBC	EXE	DS	37	0046	04.0	17-20