DOOR SPECIFICATIONS

PORTE METAL

Customer : DEMATHIEU BARD

Chantier : Affaire 1390 : ITER
Bâtiment : B37
Level : Ground Floor L1

Door Number : 63-37-L1-DO-0026 - (P21)

Location : Fluid sub-station

Clear Passage Wall :	Real clear Passage Wall :	Date	Clear Passage Validated :
~~Widht : 1990 mm~~	Widht : mm	**/**/**	Widht : 1992 mm
~~Height : 2625 mm~~ (1)	Height : mm		Height : 2575 mm ~~(2)~~ 4

Clear passage Widht : (180°) : 923+923=1845 mm
Clear passage Widht : (90°) : 1807 mm ~~(1)~~ ~~(2)~~ 4
Clear passage Height : 2497 mm

Support : --

Ind : 0	Date : 08/02/2022	Ind ~~(2)~~	Date : 07/08/2023
Ind (1)	Date : 25/01/2023	4	

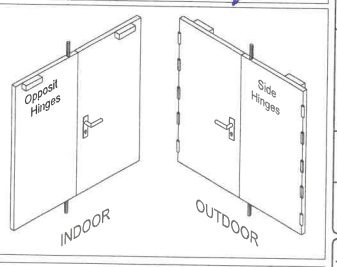

Brand's Door	PORTEMETAL
MSF : 37-0009	PREMIUM FONO - RC2
Door Performance : Fire Rating EI 90 25 dB	Frame type : TUNNEL (1)
Opening side	RIGHT Hand
RAL:	7022

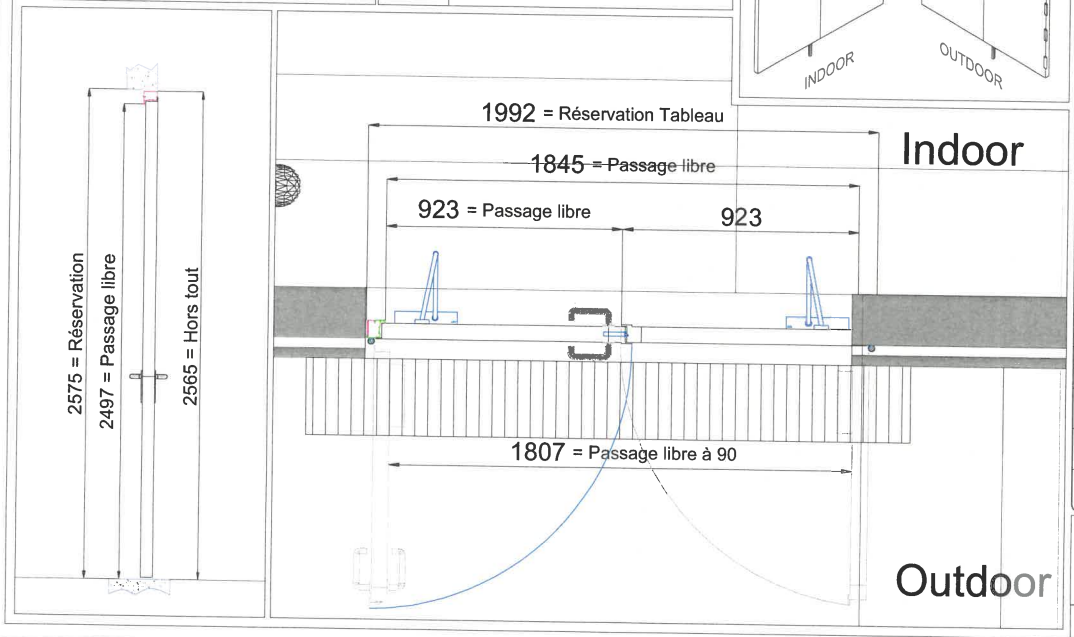

Repère	Equipments	Réf :	n° MSF
1	Handle to Stainless steel	PF1X	37-0025
2	Mechanical Lock 3pts	TCAN	37-0026
3			37-0025
4	European Cylinder Lock 45x45	C2	
5	Cremone bolts	BA33	37-0029
6	2 Door closer (OPPOSIT Hinges)	TS83	37-0027
7	Close Selector	SF1	
8			
9	2 End stop	AC14	(1)

Bon pour accord le : 8/08/2023
Nom + Signature : SERRESSEQUE

Une validation est Définitive et aucune modification ne pourra être accordée.

Note : See to Doors Schedules : ARCHI-DBC-MRR-GL-37-0006

SUPPLIER DRAWING NO.	REV.	VER.
DBC_EXE_DS_37_0046 (a)	04	0

ISSUER / SUPPLIER : DEMATHIEU BARD CONSTRUCTION
SUBCONTRACTOR : PORTE METAL

CONFIDENTIAL
© Fusion for Energy 2009
Reproduction or dissemination of this drawing is not authorized without the express written agreement of Fusion for Energy

F4E Barcelona

PHASE: PBS.63.37. CONSTRUCTION DESIGN
TITLE: Doors Specification - DO-0026 - P21

SHEET SIZE	SCALE	ISSUER ID	LIBRARY	DOC TYPE	DOC FAMILY	NUMBER	REVISION	SHEETS
A3	N/A	DBC	EXE	DS	37	0046	04.0	19-20